WRIGHT BROS. INC.
WELDING & SHEETMETAL
LICENSE # 393679
David R. Wright
5130 FAIRVIEW ROAD
HOLLISTER, CA 95023
(831) 637-2789
FAX (831) 637-3645
wbw@razzolink.com




ELEVATION - NORTH — GRAPHIC SCALE 1/2 2/2
PT. PINOS LIGHTHOUSE




ELEVATION - WEST — GRAPHIC SCALE 2 2/2
PT. PINOS LIGHTHOUSE

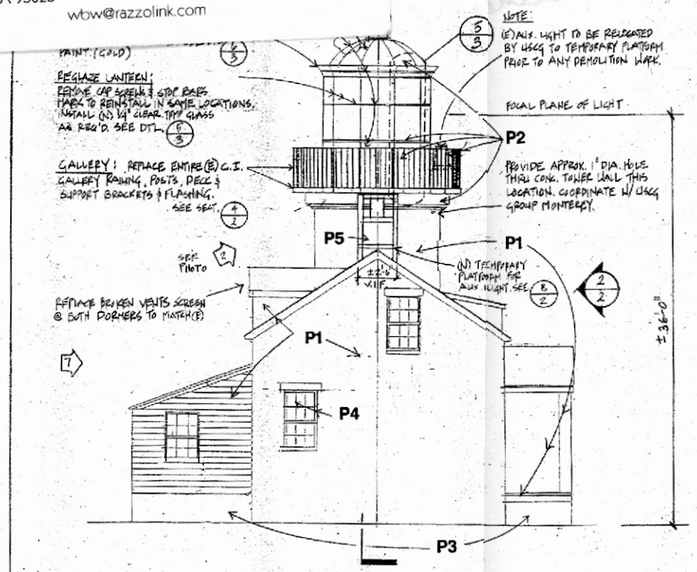


BLDG. SECTION — GRAPHIC SCALE 3 2/2
LOOKING WEST

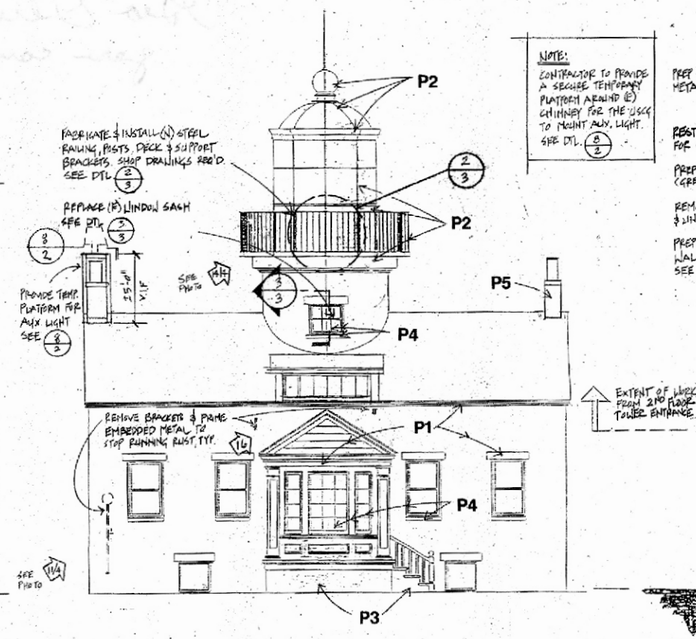


SECTION — GRAPHIC SCALE 4 2/2
LIGHTHOUSE CUPOLA

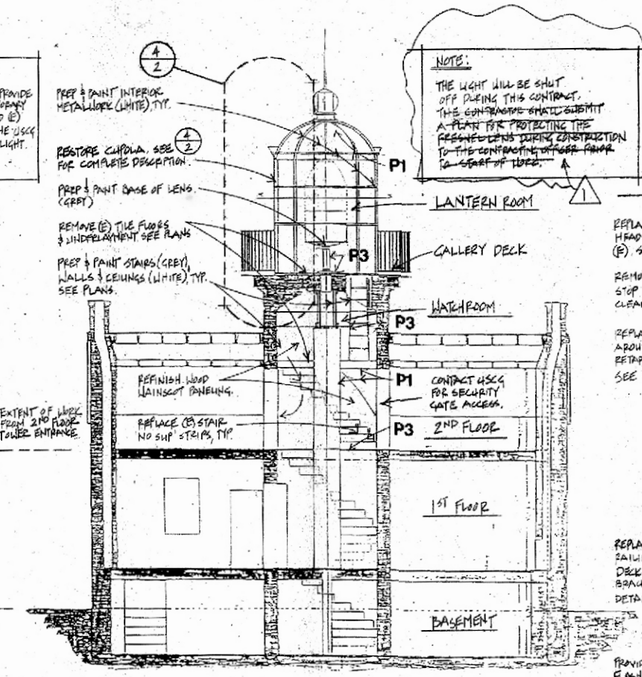


PLAN — 1/4" = 1'-0" — 5 2/2
WATCH ROOM

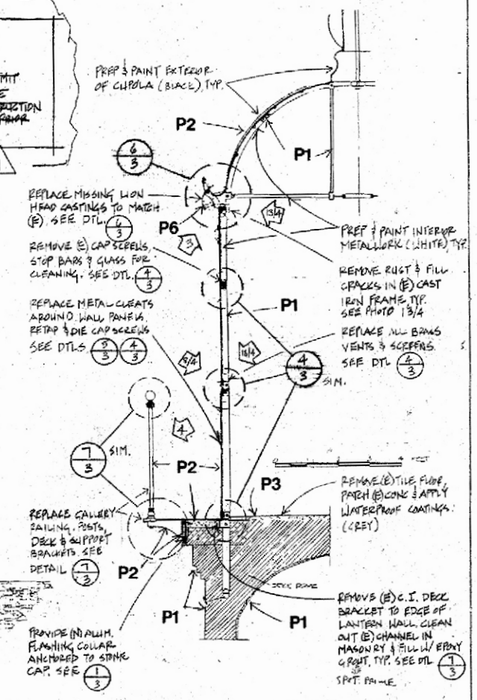


PLAN — 1/4" = 1'-0" — 7 2/2
LANTERN ROOM & GALLERY

SCALE FEET 0 1 2 3 4 5 10 15

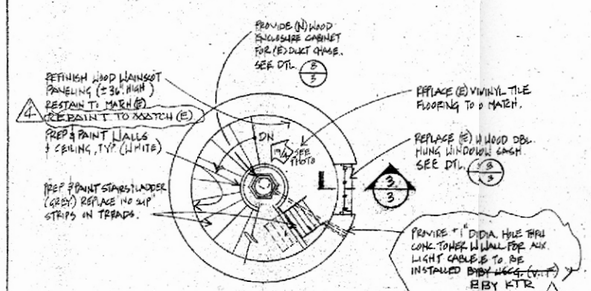PAINT SCHEDULE

COLORS: Federal Standard 595A (Change Notice 2 April, 1972)
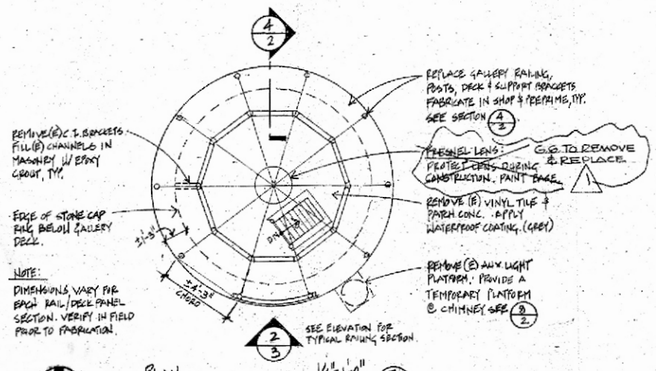
| | | |
|---|---|---|
| P1 | WHITE | - No. 17875 |
| P2 | BLACK | - No. 17038 |
| P3 | GRAY | - No. 16251 |
| P4 | GREEN | - No. 14159 |
| P5 | RED | - No. 10076 |
| P6 | GOLD | - No. 17043 |

NOTE: See specs for complete primer and paint description.

AS-BUILT




PLAN — 1/4" = 1'-0" — 6 2/2
2ND FLOOR TOWER

NORTH




DETAIL — 1/2" = 1'-0" — 8 2/2
TEMPORARY PLATFORM FOR AUX. LIGHT

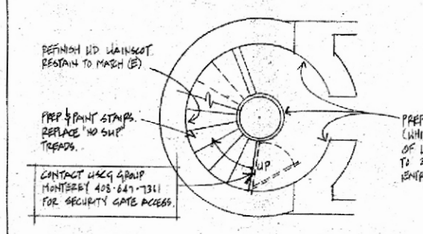


ELEV. - WEST — GRAPHIC SCALE 9 2/2
PAINT LOCKER

ELEV - NORTH — 10 2/2
PAINT LOCKER
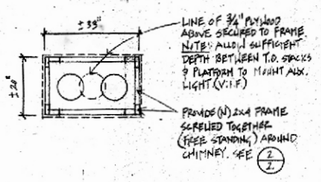
| REV. | DATE | APPR. | DESCRIPTION | BY |
|---|---|---|---|---|
| 4 | 8/30/94 | RCK | REPAINT/RESTAIN WSCT. TO MATCH (E) | RR |
| 3 | 4/26/94 | RCK | REMOVE PAINT FROM COPPER DOME AND SEAL COPPER | RR |
| 2 | 5/16/94 | RCK | REWIRING TO BE BY KTR (AUXILIARY LIGHT) | RR |
| 1 | 5/26/94 | RCK | FRESNEL LENS - WORK BY COAST GUARD - NIC | RR |

DESIGNED: DRAWN: TRACED: CHECKED: REVIEWED BY: PROJECT MANAGER REVIEWED BY:

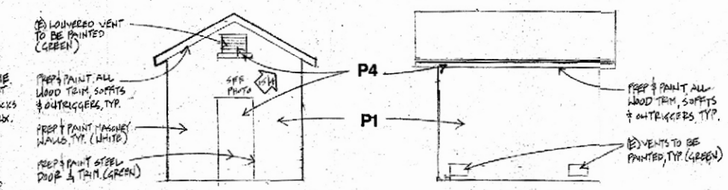U.S. COAST GUARD — OAKLAND, CA
CIVIL ENGINEERING UNIT OAKLAND
USCG GROUP MONTEREY — CALIFORNIA

**POINT PINOS LIGHTHOUSE REHAB**

PLANS, ELEVATIONS & SECTIONS

APPROVED: M. J. Kennedy, LT, ACTING — DATE: 12/11/93
CHIEF CIVIL/ARCHITECTURAL DIVISION

DRAWING NUMBER: 11-02380-2
SCALE: AS NOTED — SHEET 2 OF 5